


Pool

See attached sheet

AREA 'C' FLOOR PLAN - LEVEL 0.00
1/8" = 1'-0" A1-00

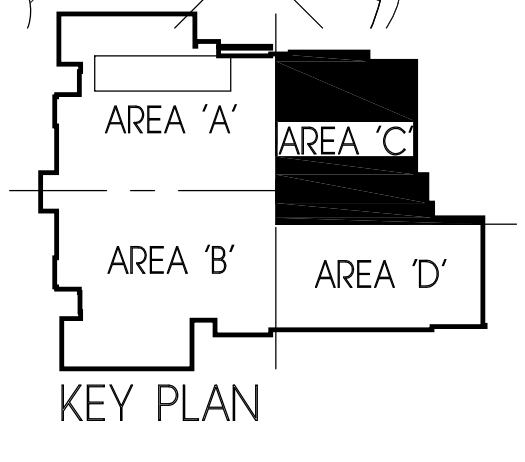

LEVEL 0.00 INCLUDES
LEVEL 0.20 @ EL. 42'-8"
LEVEL 0.42 @ EL. 44'-0 1/2"
LEVEL 0.63 @ EL. 46'-2"

RECORD DRAWINGS

NORTHEAST ADDITION
EAST HIGH SCHOOL

A1-00
15 JULY 2005
BCDM NO. 4077
DWG NO. 0409091

DES MOINES INDEPENDENT COMMUNITY SCHOOL DISTRICT
BERINGER CACCIO DENNELL MABREY - ARCHITECTURE, LANDSCAPE ARCHITECTURE, INTERIOR DESIGN, CONSTRUCTION MANAGEMENT

OMAHA DES MOINES

